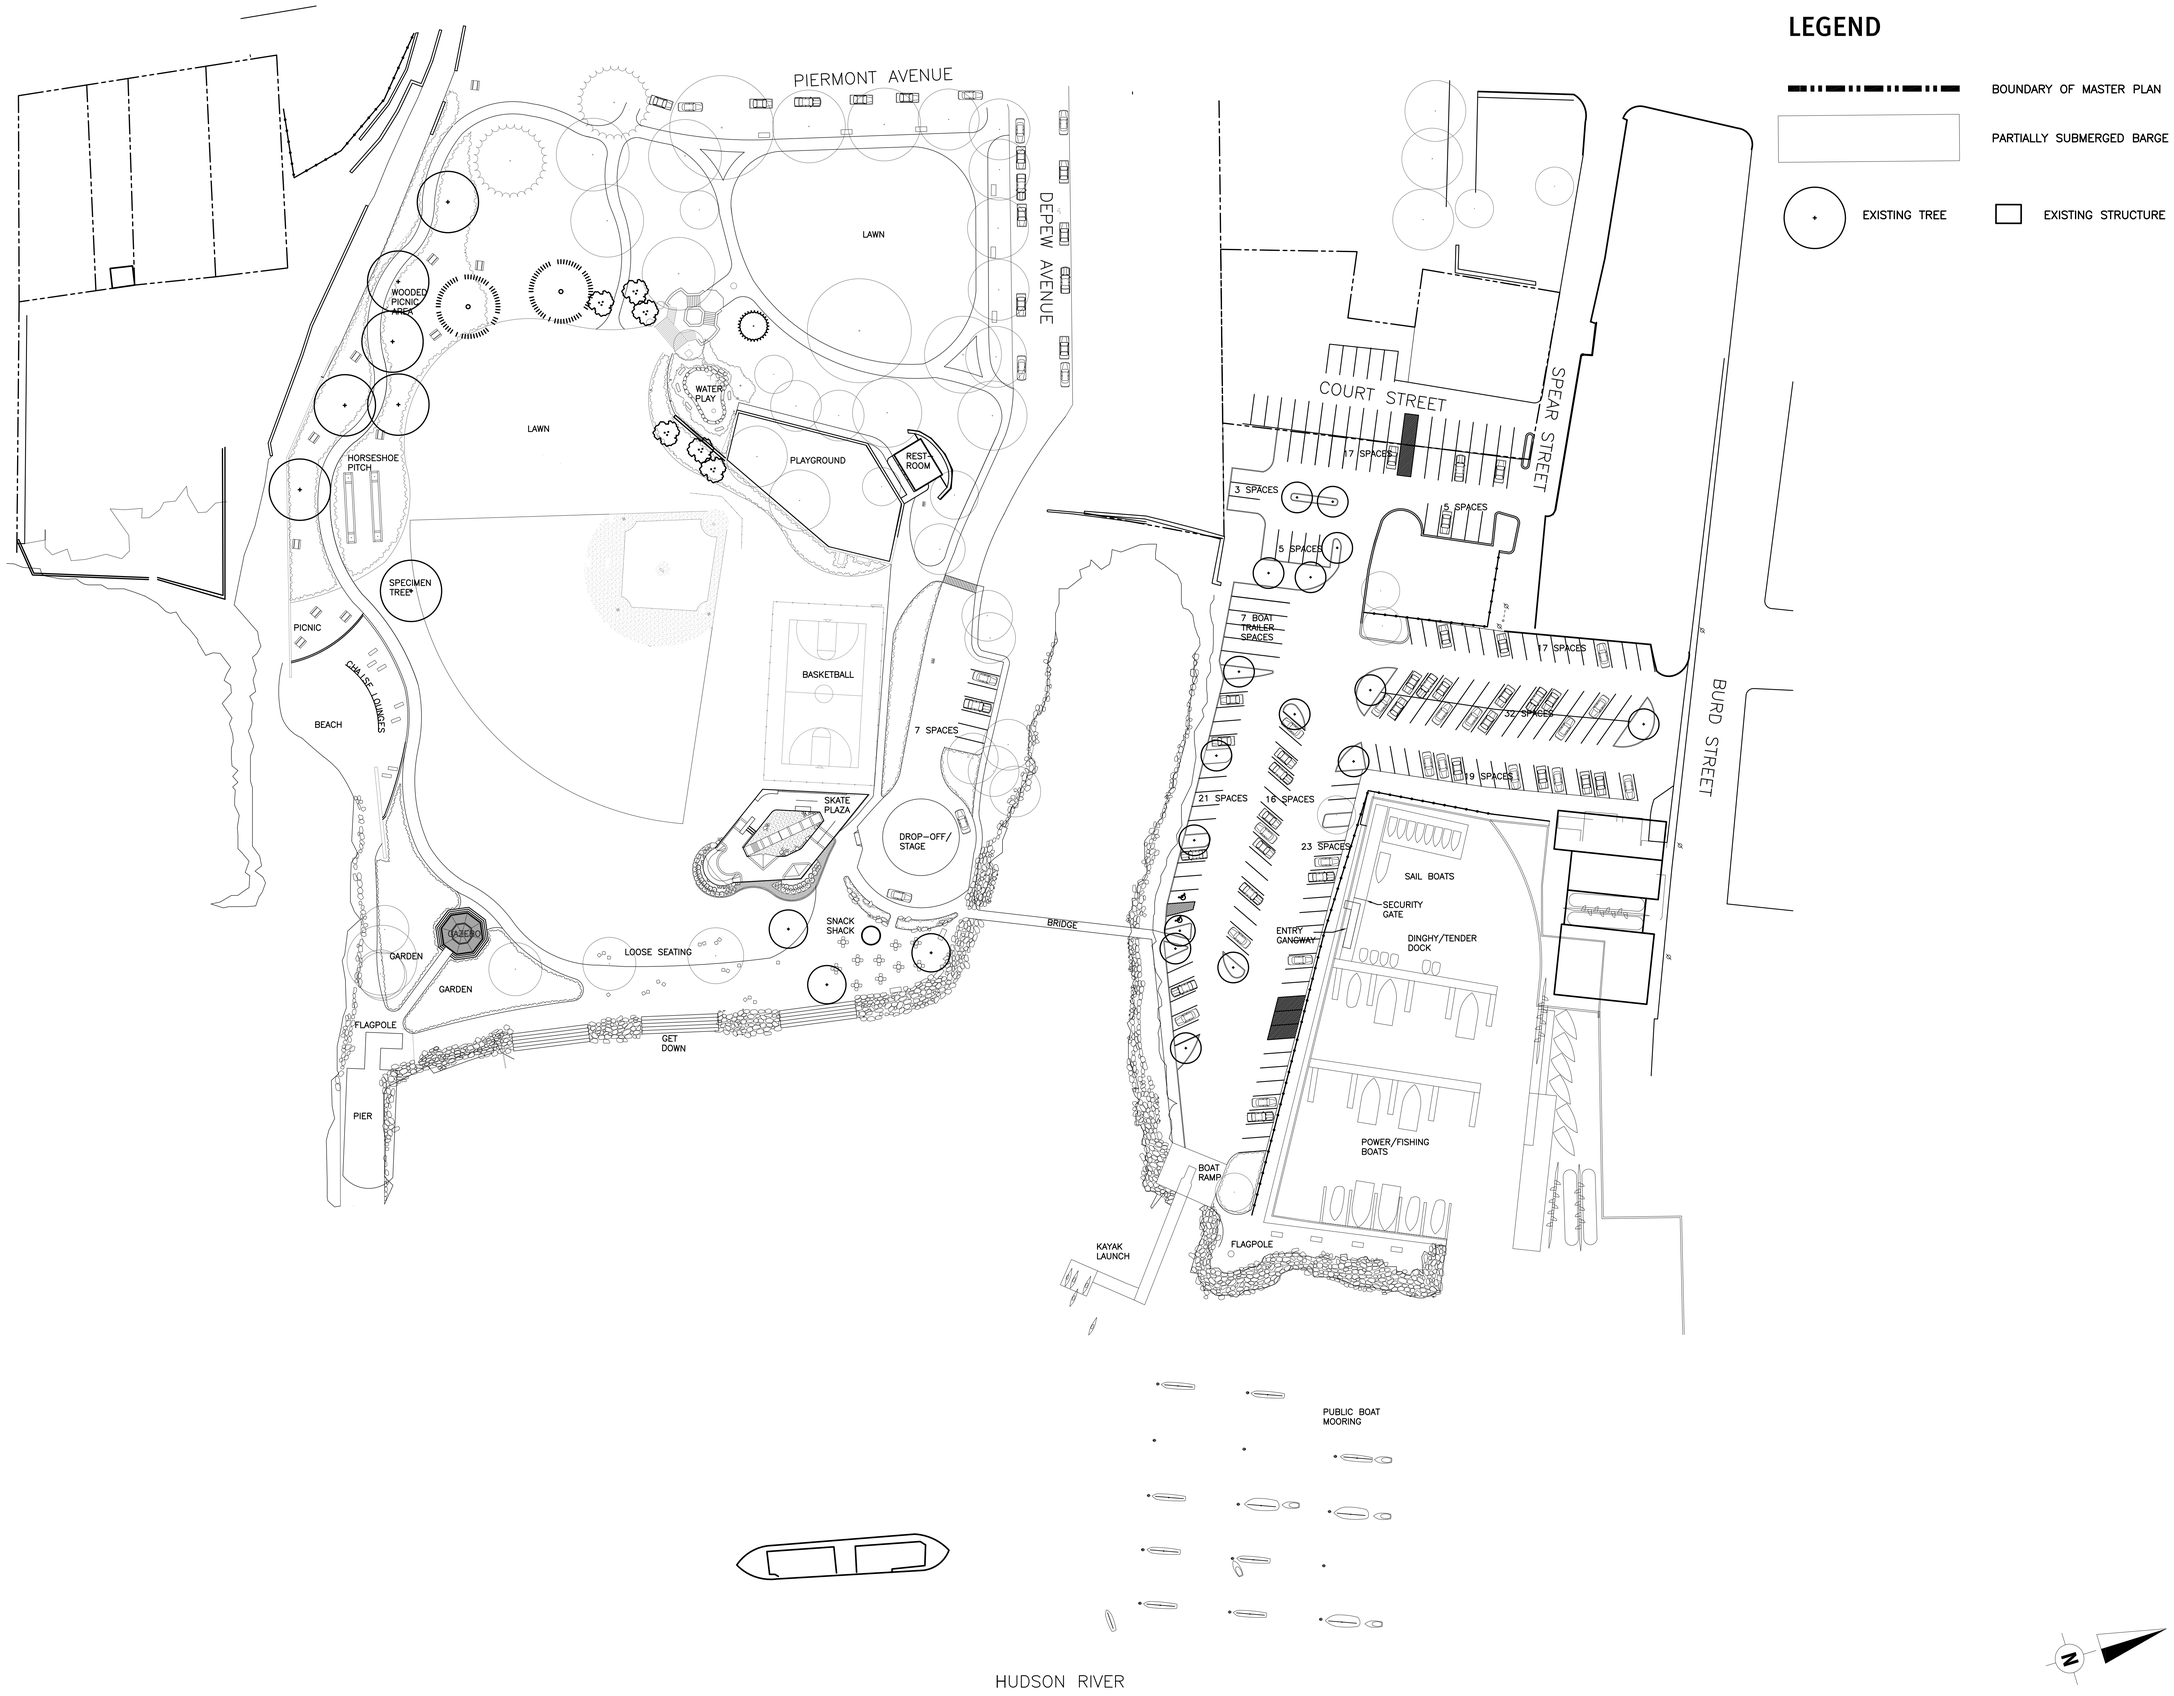

LEGEND

BOUNDARY OF MASTER PLAN

PARTIALLY SUBMERGED BARGE

EXISTING TREE

EXISTING STRUCTURE

NYACK MEMORIAL PARK

The Village of Nyack
9 North Broadway, Nyack, NY 10960
(845) 358-0229

Quennell Rothschild & Partners, LLP
Landscape Architects, Architects & Planners
118 West 22nd Street, New York, NY 10011
(212) 929-3330

revisions

project:

Master Plan

drawing title:

As-built
Pier Plan 2015

scale: 1" = 40'-0"

date: 10/21/15

drawing no.: L-1